
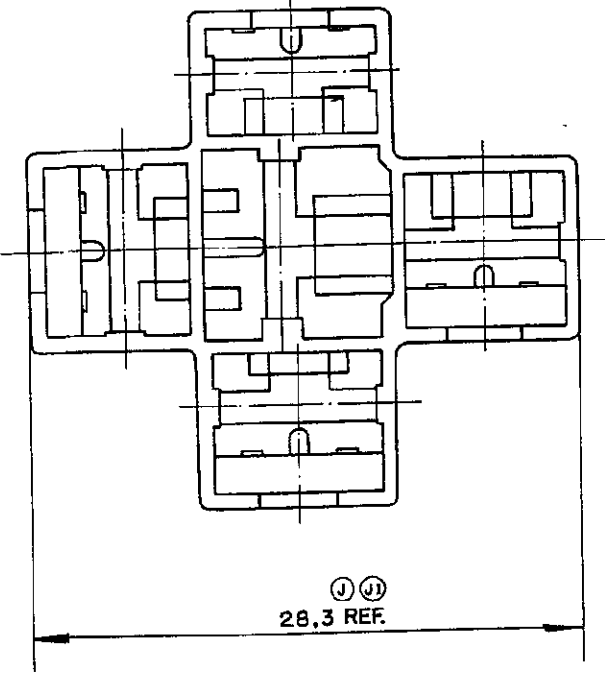
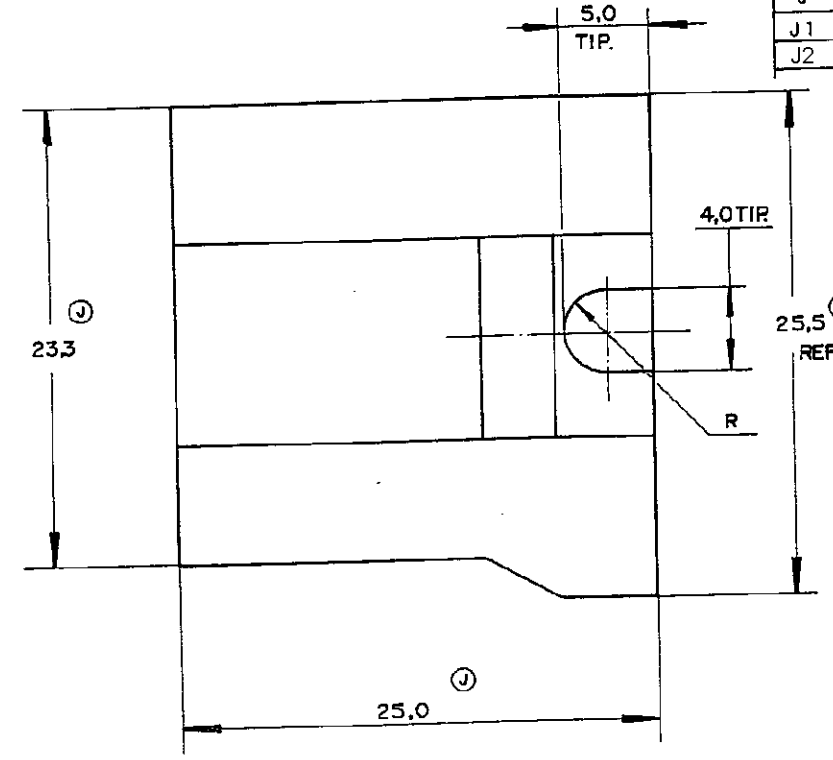


DRAWING MADE IN THIRD ANGLE PROJECTION

© Copyright 1982 by AMP DO BRASIL - S.P. All International Rights Reserved.  
AMP Incorporated products covered by U.S. and Foreign patents and/or patents pending.

REVISIONS						
P	F	ZONE	LTR	DESCRIPTION	DATE	APPROVED
			G	REDESENHADO	28.1.82	<i>[Signature]</i>
			H	ERA 8,5 E 16,8 PASSOU P/ 8,8 E 17,4	27NOV89	DOR <i>[Signature]</i>
			J	REVISADO EC 081/96	30/01/96	<i>[Signature]</i>
			J1	REVISADO EC 130/96	30/01/96	Briz <i>[Signature]</i>
			J2	REV PER ECO-09-026444	27NOV09	KK/AEG

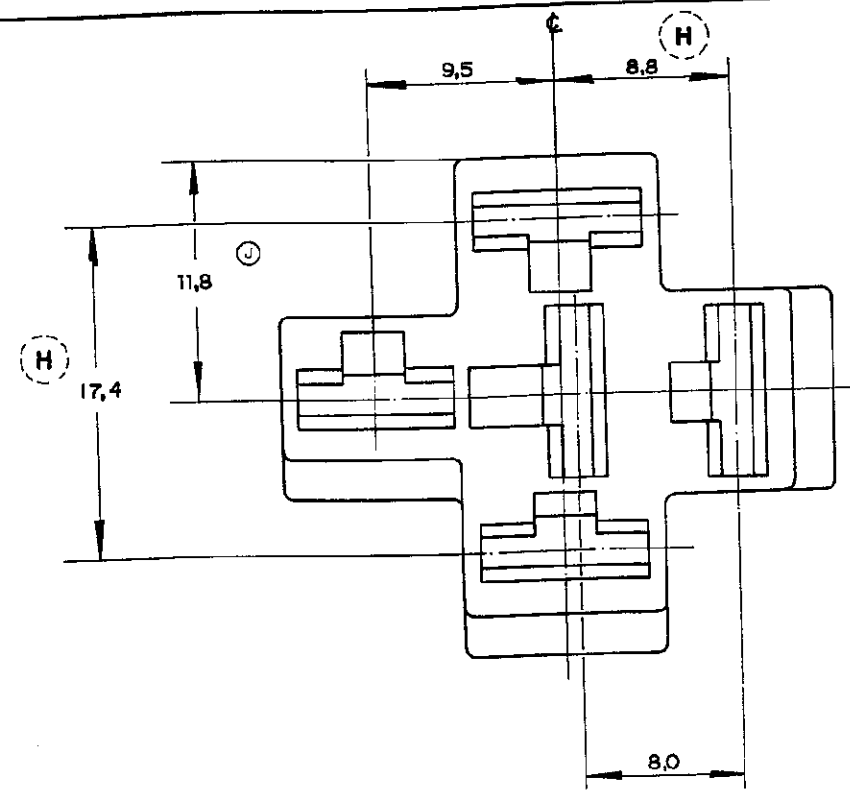

OBSOLETE	LARANJA	POLIPROPILENO	<del>626040-9</del>
	VIOLETA		<del>626040-8</del>
	CINZA		<del>626040-7</del>
	MARRON		<del>626040-6</del>
	PRETO		<del>626040-5</del>
	AMARELO		<del>626040-4</del>
	AZUL		<del>626040-3</del>
	VERDE		<del>626040-2</del>
	VERMELHO		<del>626040-1</del>
	NATURAL	POLIPROPILENO	626040-0
OBSOLETE	LARANJA	NYLON 6/6	626040-9
	VIOLETA		626040-8
	CINZA		626040-7
	MARRON		626040-6
	PRETO		626040-5
	AMARELO		626040-4
	AZUL		626040-3
	VERDE		626040-2
	VERMELHO		626040-1
	NATURAL	NYLON 6/6	626040-0
COR	MATERIAL	PART N°	

**NOTA:**

1- LINHA DE CENTRO MOSTRADA É A LINHA DE CENTRO DAS LINGUETAS  
 2 OBSOLETE PARTS: OBSOLETE CIS STREAMLINING PER D.RENAUD/D.SINISI

UNLESS OTHERWISE SPECIFIED DIMENSIONS ARE IN MM TOLERANCES ON: DECIMALS ±0.3 ANGLES ±1°	CONTRACT NO	AMP DO BRASIL S. Paulo - Brasil
	DR <i>[Signature]</i> 29/01/82	
	CHK <i>[Signature]</i> 29-01-82	NAME
	MATERIAL	RELAY BASE MOULDING
VER TABELA	APPD	SIZE B
FINISH	APPD	LOC AP.
VER TABELA	DSGN APPD	DRAWING NO
	OTHER APPD	626040
		SCALE
		SHEET
		REV. J2

CUSTOMER DRAWING