DO NOT SCALE PRINT

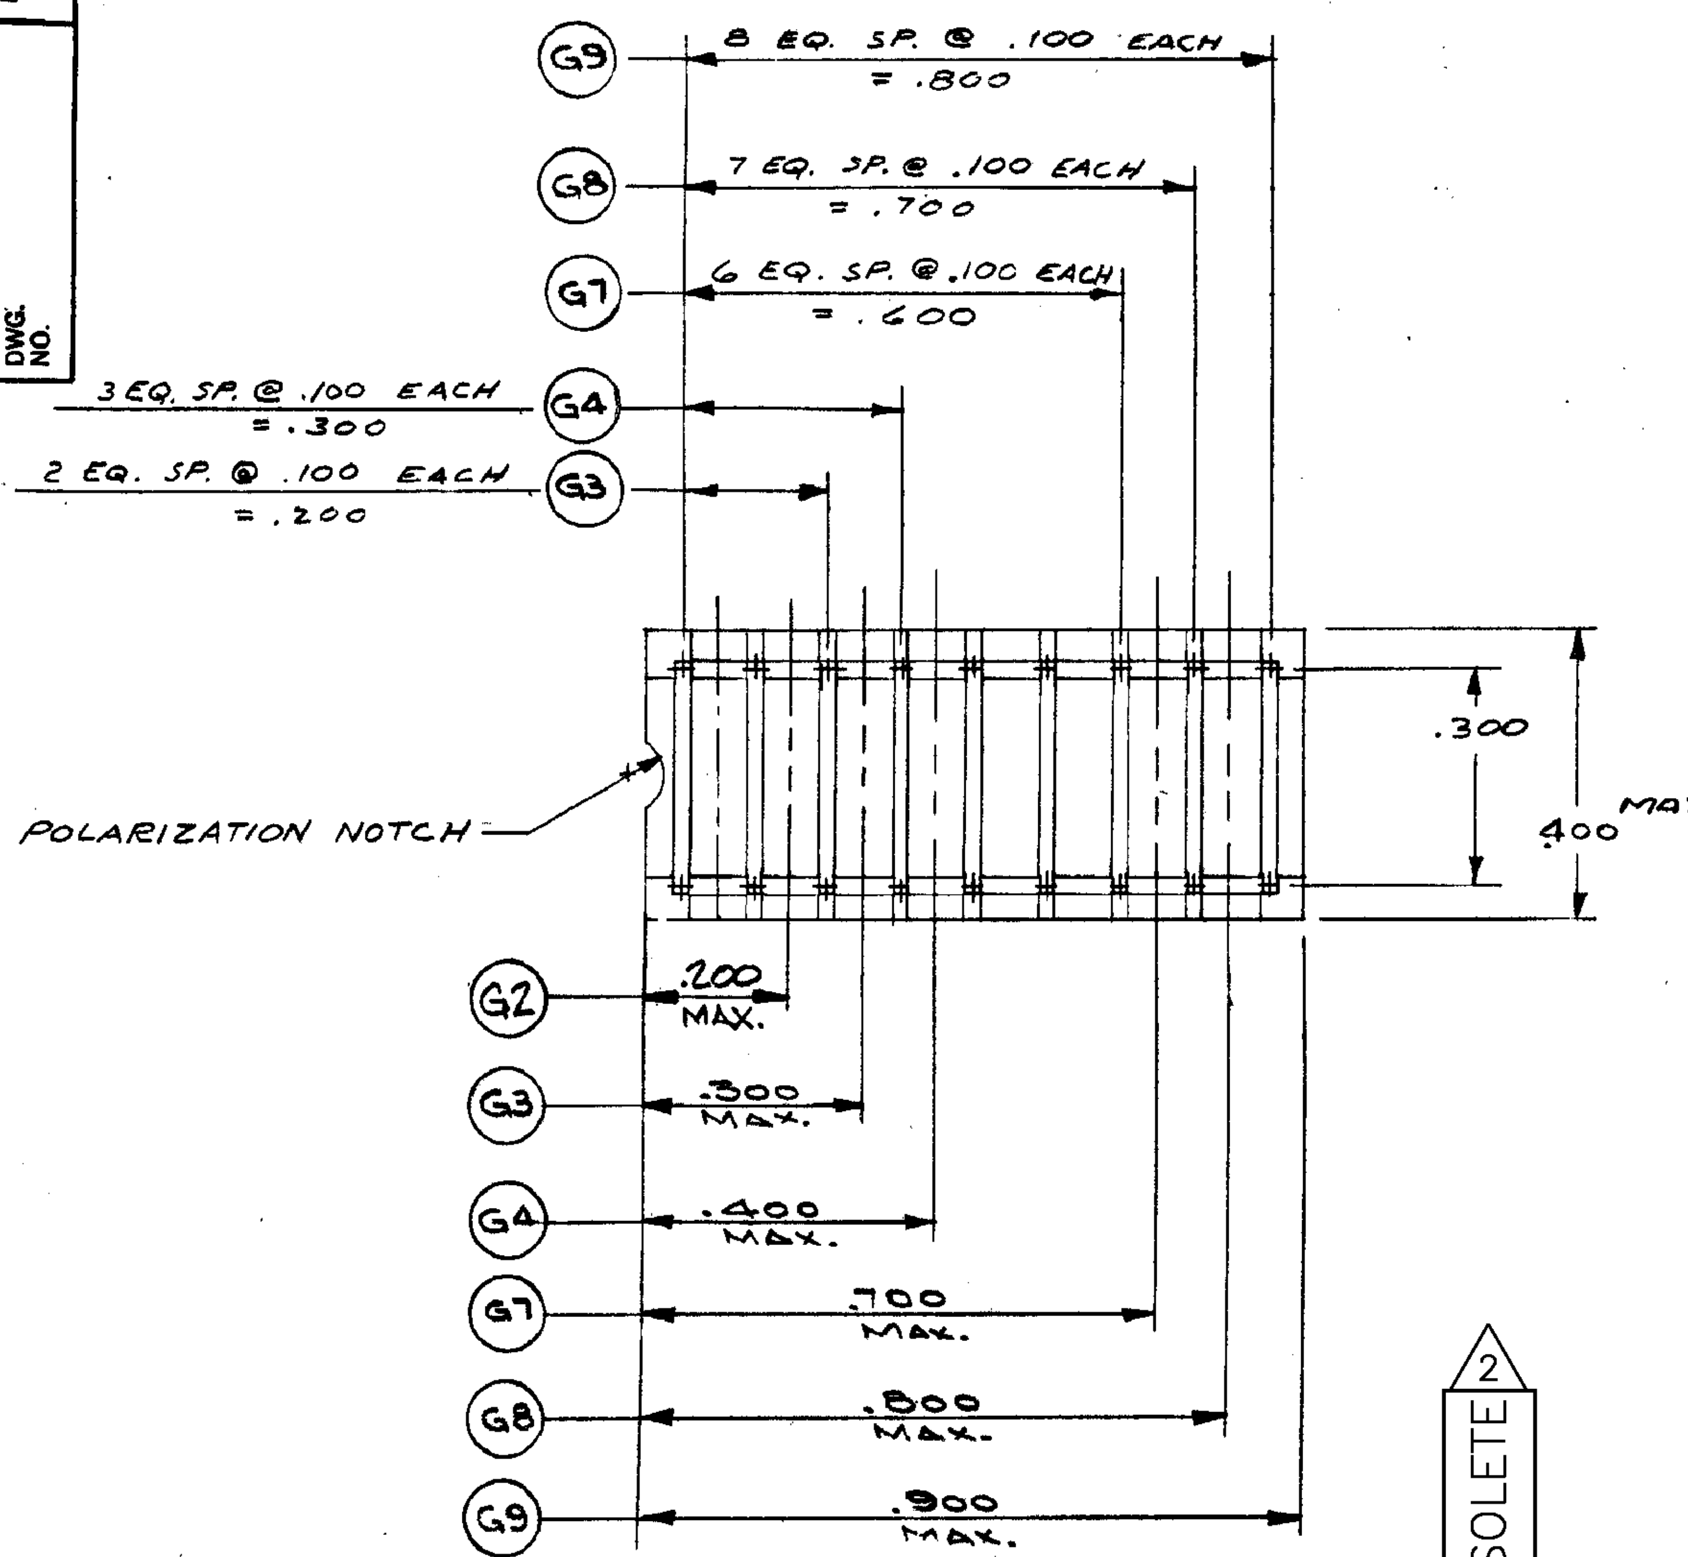

NOTES:

1. MATERIAL AND FINISH:
   INSULATOR ____ THERMOPLASTIC POLYESTER UL RATED 90 V-O; COLOR-BLACK
   (G) CONTACT ____ PHOSPHOR BRONZE, GOLD OVER NICKEL PLATE
   (GT) CONTACT ____ PHOSPHOR BRONZE, TIN PLATE.

△2 OBSOLETE PARTS: OBSOLETE CIS STREAMLINING PER D.RENAUD/D.SINISI

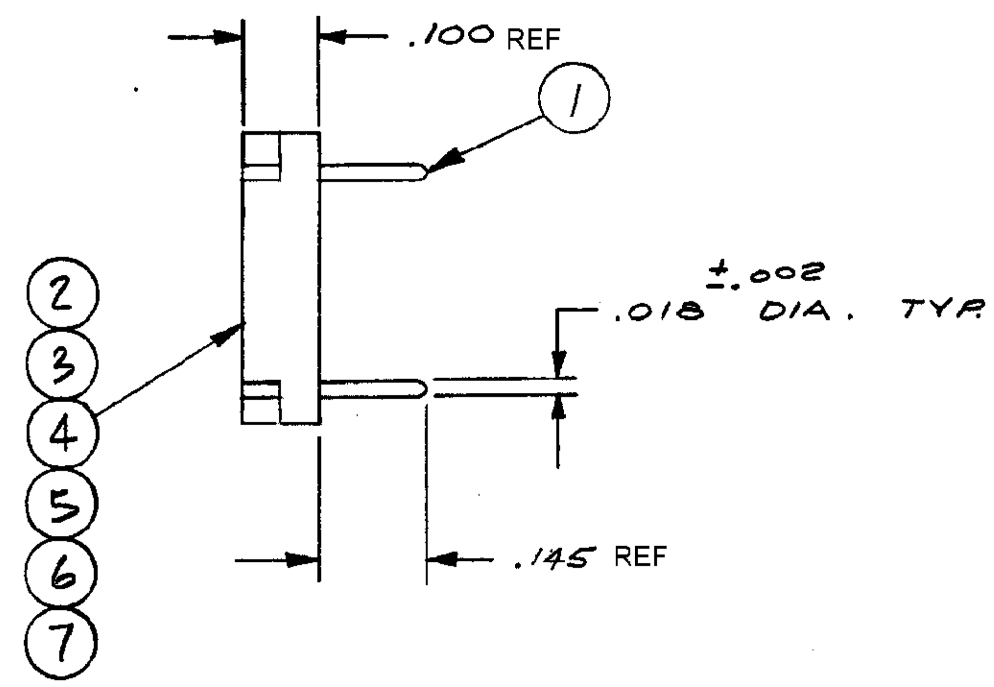

TYCO ELECTRONIC PART NO.S

G25	G24	G23	G2T	G9T	G8T	G7T	G4T	G3T	G2	G9	G8	G7	G4	G3	DESCRIPTION	ITEM NO.
N/A	~~1-1437507-2~~ OBSOLETE △2	1-1437507-1	N/A	~~3-1437506-2~~ SUP BY 2-1437507-1	2-1437507-0	~~1-1437507-8~~ OBSOLETE △2	1-1437507-6	~~1-1437507-4~~ OBSOLETE	1-1437507-0	2-1437507-1	1-1437507-9	1-1437507-7	1-1437507-5	1-1437507-3		
9	8	7													SHORTING PIN	1
			2	9	8	7	4	3							SHORTING PIN	1
			1						1						INSULATOR	7
1				1						1					INSULATOR	6
	1				1						1				INSULATOR	5
		1				1						1			INSULATOR	4
							1						1		INSULATOR	3
								1						1	INSULATOR	2
									2	9	8	7	4	3	SHORTING PIN	1
QUANTITY									QUANTITY							

REV- A
DESCRIPTION-
REV PER
ECO-10-000445
DATE- 28JAN10
DR / APVD- KK / HMR

UNLESS OTHERWISE SPECIFIED DIMENSIONS ARE IN INCHES
TOLERANCES ON
FRACTIONS – DECIMALS REF ANGLES --

MATERIAL: —

FINISH: —

ORIGINAL DATE OF DRAWING:	4-4-73
DRAWN: RJS	DATE: 4-4-74
CHECKED: R.J.H.	DATE: 4-5-74
APPROVED: R.J.H.	DATE: 4-5-74
CODE IDENT. NO. 91506	DWG. SIZE C
NEXT ASSY.	

AUGAT INC. 33 Perry Avenue Attleboro, Mass. 02703

TITLE: PROGRAMMING PLUG

DWG. NO. 8136-475 REV. A

SCALE: 4X1 SHEET 1 OF 1

Printed in U.S.A.

CUSTOMER DWG. 1-1437507-0 REV.

Property of Tyco Electronics Corporation, Dec 3 2003
CUSTOMER DRWG: 1-1437507-0 REV: A PG 1 OF 1